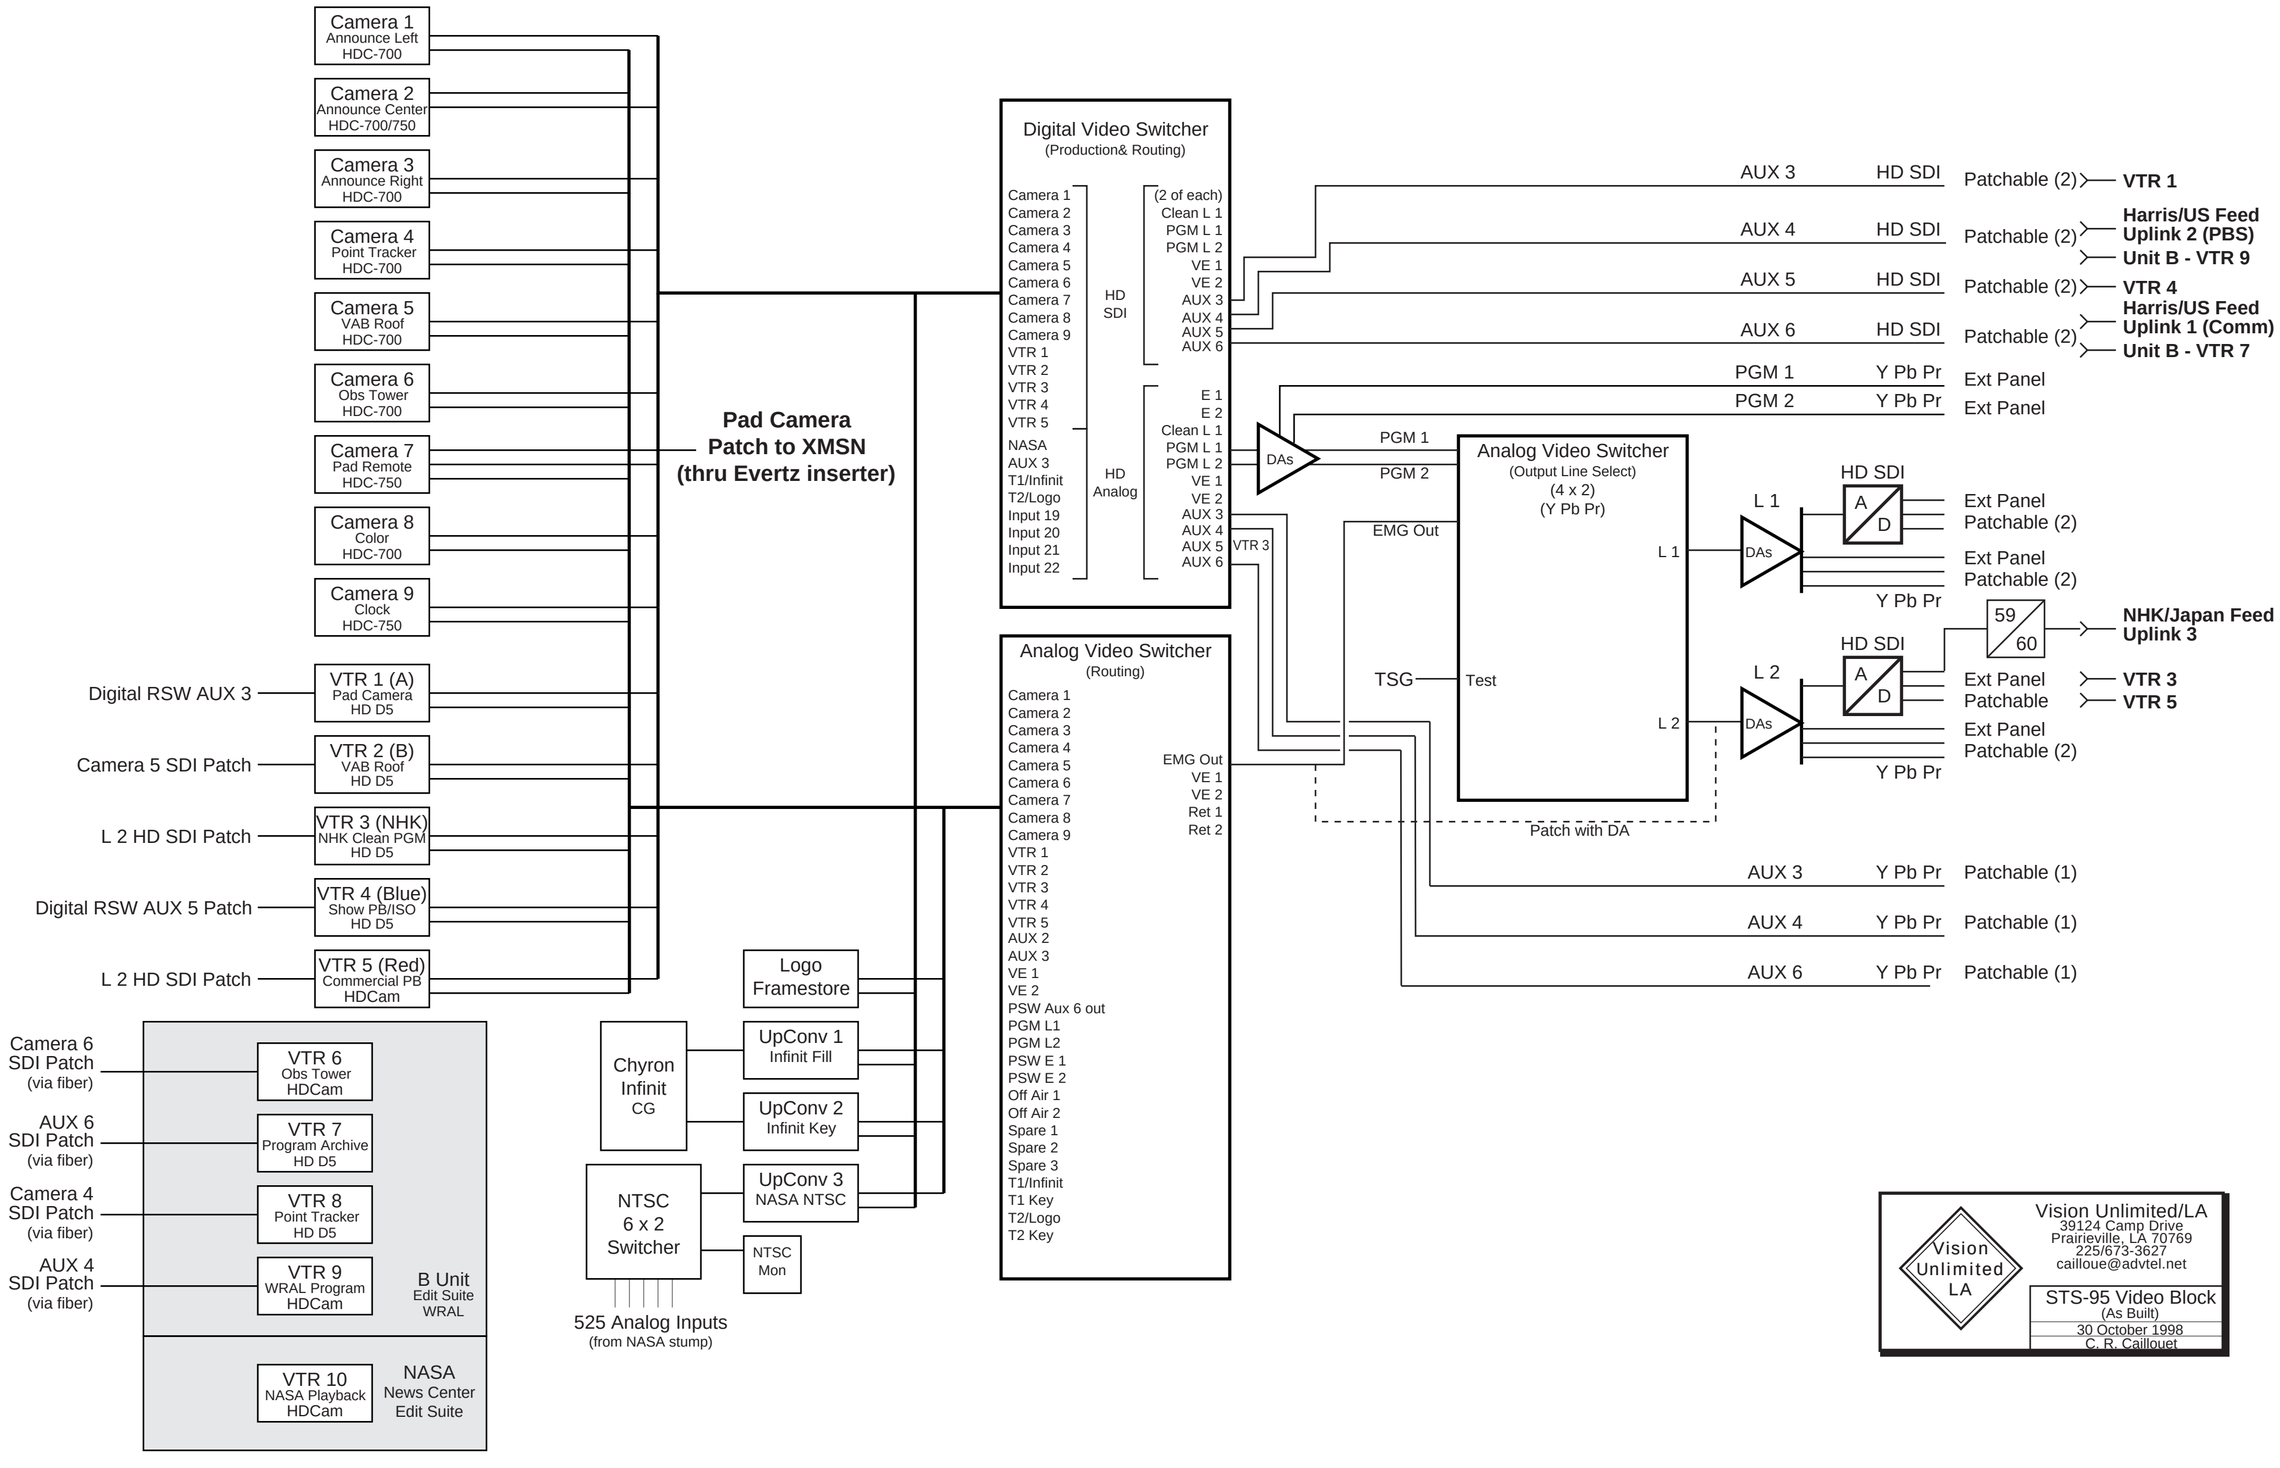
Camera 1
Announce Left
HDC-700
Camera 2
Announce Center
HDC-700/750
Camera 3
Announce Right
HDC-700
Camera 4
Point Tracker
HDC-700
Camera 5
VAB Roof
HDC-700
Camera 6
Obs Tower
HDC-700
Camera 7
Pad Remote
HDC-750
Camera 8
Color
HDC-700
Camera 9
Clock
HDC-750
Digital RSW AUX 3
VTR 1 (A)
Pad Camera
HD D5
Camera 5 SDI Patch
VTR 2 (B)
VAB Roof
HD D5
L 2 HD SDI Patch
VTR 3 (NHK)
NHK Clean PGM
HD D5
Digital RSW AUX 5 Patch
VTR 4 (Blue)
Show PB/ISO
HD D5
L 2 HD SDI Patch
VTR 5 (Red)
Commercial PB
HDCam
Pad Camera
Patch to XMSN
(thru Evertz inserter)
Digital Video Switcher
(Production& Routing)
Camera 1
Camera 2
Camera 3
Camera 4
Camera 5
Camera 6
Camera 7
Camera 8
Camera 9
VTR 1
VTR 2
VTR 3
VTR 4
VTR 5
NASA
AUX 3
T1/Infinit
T2/Logo
Input 19
Input 20
Input 21
Input 22
HD SDI
(2 of each)
Clean L 1
PGM L 1
PGM L 2
VE 1
VE 2
AUX 3
AUX 4
AUX 5
AUX 6
HD Analog
E 1
E 2
Clean L 1
PGM L 1
PGM L 2
VE 1
VE 2
AUX 3
AUX 4
AUX 5
AUX 6
VTR 3
DAs
PGM 1
PGM 2
EMG Out
TSG
Analog Video Switcher
(Output Line Select)
(4 x 2)
(Y Pb Pr)
Test
L 1
L 2
Patch with DA
Analog Video Switcher
(Routing)
Camera 1
Camera 2
Camera 3
Camera 4
Camera 5
Camera 6
Camera 7
Camera 8
Camera 9
VTR 1
VTR 2
VTR 3
VTR 4
VTR 5
AUX 2
AUX 3
VE 1
VE 2
PSW Aux 6 out
PGM L1
PGM L2
PSW E 1
PSW E 2
Off Air 1
Off Air 2
Spare 1
Spare 2
Spare 3
T1/Infinit
T1 Key
T2/Logo
T2 Key
EMG Out
VE 1
VE 2
Ret 1
Ret 2
Logo
Framestore
Chyron
Infinit
CG
UpConv 1
Infinit Fill
UpConv 2
Infinit Key
NTSC
6 x 2
Switcher
UpConv 3
NASA NTSC
NTSC
Mon
525 Analog Inputs
(from NASA stump)
Camera 6
SDI Patch
(via fiber)
AUX 6
SDI Patch
(via fiber)
Camera 4
SDI Patch
(via fiber)
AUX 4
SDI Patch
(via fiber)
VTR 6
Obs Tower
HDCam
VTR 7
Program Archive
HD D5
VTR 8
Point Tracker
HD D5
VTR 9
WRAL Program
HDCam
B Unit
Edit Suite
WRAL
VTR 10
NASA Playback
HDCam
NASA
News Center
Edit Suite
AUX 3
HD SDI
Patchable (2)
VTR 1
AUX 4
HD SDI
Patchable (2)
Harris/US Feed
Uplink 2 (PBS)
Unit B - VTR 9
AUX 5
HD SDI
Patchable (2)
VTR 4
AUX 6
HD SDI
Patchable (2)
Harris/US Feed
Uplink 1 (Comm)
Unit B - VTR 7
PGM 1
Y Pb Pr
Ext Panel
PGM 2
Y Pb Pr
Ext Panel
L 1
DAs
HD SDI
A
D
Ext Panel
Patchable (2)
Ext Panel
Patchable (2)
Y Pb Pr
59
60
NHK/Japan Feed
Uplink 3
L 2
DAs
HD SDI
A
D
Ext Panel
Patchable
VTR 3
VTR 5
Ext Panel
Patchable (2)
Y Pb Pr
AUX 3
Y Pb Pr
Patchable (1)
AUX 4
Y Pb Pr
Patchable (1)
AUX 6
Y Pb Pr
Patchable (1)
Vision Unlimited LA
Vision Unlimited/LA
39124 Camp Drive
Prairieville, LA 70769
225/673-3627
cailloue@advtel.net
STS-95 Video Block
(As Built)
30 October 1998
C. R. Caillouet